

DRAWINGS

FOR

**INTUITECH
PILOT MODULE ENCLOSURE B500**

PROJECT 1675

FOR

INSTALLATION

RELEASE #1

MARCH 10, 2021

1	2	3	4	5	6	7	8	9	10	11	12	13	14	15	16	17	18	19	20	21	22	23	24
DEVICE SYMBOLS				INSTRUMENTATION				PROCESS EQUIPMENT				PUMPS/BLOWERS				VALVES				CONTROL PHILOSOPHY			
FIELD MOUNTED DEVICE ENCLOSURE MOUNTED DEVICE BACKPLANE MOUNTED DEVICE PROGRAMMABLE OPERATOR INTERFACE (ENCLOSURE MOUNTED) PROGRAMMABLE LOGIC CONTROLLER (BACKPLANE MOUNTED)				VARIABLE AREA FLOWMETER PADDLE WHEEL/ TURBINE FLOWMETER MAGNETIC FLOWMETER LAMINAR FLOWMETER VORTEX SHEDDING FLOWMETER THERMAL DISPERSION FLOWMETER ULTRASONIC LEVEL DEVICE OPTICAL DISTANCE TRANSMITTER FLOAT LEVEL DEVICE SIGHT LEVEL DEVICE GUIDED WAVE RADAR LEVEL DEVICE PRESSURE DEVICE CAPACITIVE LEVEL DEVICE				ELECTRIC MIXER HEAT EXCHANGER HEATER STATIC MIXER PIPE WEIR WITH AIR BREAK EDUCTOR FILTER / STRAINER COALESCING FILTER ORIFICE PLATE RUPTURE DISK PRESSURE GAUGE ISOLATOR PIPE REDUCER FLOW THROUGH CELL INSPECTION LIGHT				BLOWER CENTRIFUGAL PUMP DIAPHRAGM PUMP FLEXIBLE IMPELLER PUMP BI-DIRECTIONAL FLEXIBLE IMPELLER PUMP PERISTALTIC PUMP PROGRESSIVE CAVITY PUMP ROTARY LOBE PUMP GEAR PUMP COMPRESSOR				NEEDLE VALVE BUTTERFLY VALVE BALL VALVE CHECK VALVE GLOBE VALVE DIAPHRAGM VALVE GATE VALVE 3-WAY BALL VALVE 3-WAY GENERAL VALVE PLUG VALVE GENERAL VALVE AIR RELIEF VALVE VACUUM RELIEF VALVE PRESSURE / SAFETY RELIEF VALVE				SEQUENCER STEP DECISION OPERATOR INPUT PROCESS REFERENCE TO A DIFFERENT PAGE IF CONDITION IS TRUE CONTINUE			
MISCELLANEOUS																							
MINOR PROCESS LINE MAJOR PROCESS LINE ELECTRICAL SIGNAL WATER SURFACE DOUBLE WALL PIPE MAJOR ARROW MINOR ARROW PROCESS VALUE POINT DRAIN WITH AIR BREAK PROCESS BOUNDARY CONDUIT SEAL-OFF																							
												CONTROL FUNCTIONS				ACTUATORS							
												PROPORTIONAL, INTEGRAL & DERIVATIVE FLOW PACING SUBTRACTION PULSE WIDTH MODULATION CALCULATION SELECTION SUMMATION MULTIPLEXER TRIM SET POINT LIMITING				PRESSURE REGULATING ACTUATOR AIR-TO-OPEN/ SPRING TO CLOSE ACTUATOR AIR-TO-OPEN/ AIR-TO-CLOSE ACTUATOR AIR-TO-CLOSE/ SPRING-TO-OPEN ACTUATOR ELECTRIC ACTUATOR SOLENOID ACTUATOR HAND ACTUATOR LEVEL ACTUATOR							

REV	DATE	BY	DESCRIPTION
1			
2			
3			
4			

Intuitech
 www.intuitech.com

THIS DRAWING IS THE INTELLECTUAL PROPERTY OF INTUITECH AND MAY NOT BE REPRODUCED IN FULL OR IN PART FOR ANY PURPOSE ASIDE FROM THE PROJECT AS SPECIFIED ON THIS DOCUMENT

DIMENSIONAL TOLERANCES ARE AS FOLLOWS, UNLESS OTHERWISE SPECIFIED

FRAC: ± 1/16 0.XX: ± 0.01
 ANGLES: ± 1° 0.XXX: ± 0.005

TITLE: PROCESS & INSTRUMENTATION DIAGRAM SYMBOL LEGEND			
CLIENT:		PROJECT:	
DRAWN BY:		DRAWN DATE:	
DRAWING NAME: 0000-XXRL-01.VSD		P.O.:	
SCALE: NONE		REVISION:	

INPUT DEVICE TAG PREFIXES						
PARAMETER	ELEMENT / SENSOR	INDICATOR	TRANSMITTER		SWITCH	
			BLIND	INDICATING	HIGH	LOW
AMMONIUM	AME	AMI	AMT	AMIT	AMSH	AMSL
ANALYTICAL (UNSPECIFIED)	AE	AI	AT	AIT	ASH	ASL
CHLORINE	CHE	CHI	CHT	CHIT	CHSH	CHSL
CONDUCTIVITY	CE	CI	CT	CIT	CSH	CSL
CURRENT	CUE	CUI	CUT	CUIT	CUSH	CUSL
DISSOLVED OXYGEN	DOE	DOI	DOT	DOIT	DOSH	DOSL
FLOW RATE	FE	FI	FT	FIT	FSH	FSL
FLOW TOTALIZER	FQE	FQI	FQT	FQIT	FQSH	FQSL
HARDNESS	HE	HI	HT	HIT	HSH	HSL
HYDROGEN SULFIDE	HSE	HSI	HST	HSIT	HSSH	HSSL
LEVEL	LE	LI	LT	LIT	LSH	LSL
LOWER EXPLOSION LIMIT	LELE	LELI	LELT	LELIT	LELH	LELL
NITROGEN	NE	NI	NT	NIT	NSH	NSL
ORP	ORE	ORI	ORT	ORIT	ORSH	ORSL
OXYGEN	OXE	OXI	OXT	OXIT	OXSH	OXSL
OZONE	OZE	OZI	OZT	OZIT	OZSH	OZSL
PARTICLE	PCE	PCI	PCT	PCIT	PCSH	PCSL
PH	PHE	PHI	PHT	PHIT	PHSH	PHSL
POSITION	ZE	ZI	ZT	ZIT	ZSH	ZSL
POWER	PWE	PWI	PWT	PWIT	PWSH	PWSL
POWER TOTALIZER	PWQE	PWQI	PWQT	PWQIT	PWQSH	PWQSL
PRESSURE	PE	PI	PT	PIT	PSH	PSL
PRESSURE DIFFERENTIAL	PDE	PDI	PDT	PDIT	PDSH	PDSL
RESISTIVITY	RE	RI	RT	RIT	RSH	RSL
RELATIVE HUMIDITY	RHE	RHI	RHT	RHIT	RHSH	RHSL
SPEED	SE	SI	ST	SIT	SSH	SSL
STREAMING CURRENT	SCE	SCI	SCT	SCIT	SCSH	SCSL
SUSPENDED SOLIDS	SSE	SSI	SST	SSIT	SSSH	SSSL
TEMPERATURE	TE	TI	TT	TIT	TSH	TSL
TIME TOTALIZER	TQE	TQI	TQT	TQIT	TQSH	TQSL
TOTAL ORGANIC CARBON	TCE	TCI	TCT	TCIT	TCSH	TCSL
TURBIDITY	TUE	TUI	TUT	TUIT	TUSH	TUSL
UV ABSORPTION OR TRANSMITTANCE	UVE	UVI	UVT	UVIT	UVSH	UVSL
VOLTAGE	VE	VI	VT	VIT	VSH	VSL
WEIGHT / FORCE	WE	WI	WT	WIT	WSH	WSL

ALARM DEVICE TAG PREFIXES		
PARAMETER	HIGH	LOW
AMMONIUM	AMAH	AMAL
ANALYTICAL (UNSPECIFIED)	AAH	AAL
CHLORINE	CAH	CHAL
CONDUCTIVITY	CAH	CAL
CURRENT	CUAH	CUAL
DISSOLVED OXYGEN	DOAH	DOAL
FLOW RATE	FAH	FAL
FLOW TOTALIZER	FQAH	FQAL
HARDNESS	HAH	HAL
HYDROGEN SULFIDE	HSAH	HSAL
LEVEL	LAH	LAL
LOWER EXPLOSION LIMIT	LELH	LELL
NITROGEN	NAH	NAL
OXYGEN	OXAH	OXAL
OZONE	OZAH	OZAL
PARTICLE	CAH	PCAL
PH	PAH	PHAL
POWER	PWAH	PWAL
POWER TOTALIZER	PWQAH	PWQAL
PRESSURE	PAH	PAL
PRESSURE DIFFERENTIAL	PDAH	PDAL
RESISTIVITY	RAH	RAL
RELATIVE HUMIDITY	RHAH	RHAL
SPEED	SAH	SAL
STREAMING CURRENT	SCAH	SCAL
SUSPENDED SOLIDS	SSAH	SSAL
TEMPERATURE	TAH	TAL
TIME TOTALIZER	TQAH	TQAL
TOTAL ORGANIC CARBON	TCAH	TCAL
TURBIDITY	TUAH	TUAL
UV ABSORPTION	UVAH	UVAL
VOLTAGE	VAH	VAL
WEIGHT / FORCE	WAH	WAL

OUTPUT DEVICE TAG PREFIXES	
DESCRIPTION	TAG
CHECK VALVE	CV
DISCRETE VALVE (OPEN/CLOSED)	DV
INJECTION VALVE	IV
PILOT VALVE	YV
PRESSURE REGULATOR	PR
PROPORTIONAL VALVE (MODULATING)	PV
RELIEF VALVE	RV
SAMPLE VALVE	SV

CONTROL DEVICE TAG PREFIXES	
DESCRIPTION	TAG
FLOW CONTROLLER	FC
FLOW INDICATING CONTROLLER	FIC
PRESSURE CONTROLLER	PC
PRESSURE INDICATING CONTROLLER	PIC
SPEED CONTROLLER	SC
SPEED INDICATING CONTROLLER (VFD)	SIC
TEMPERATURE CONTROLLER	TC
TEMPERATURE INDICATING CONTROLLER	TIC

REV	DATE	BY	DESCRIPTION
1			
2			
3			
4			



THIS DRAWING IS THE INTELLECTUAL PROPERTY OF INTUITECH AND MAY NOT BE REPRODUCED IN FULL OR IN PART FOR ANY PURPOSE ASIDE FROM THE PROJECT AS SPECIFIED ON THIS DOCUMENT

DIMENSIONAL TOLERANCES ARE AS FOLLOWS, UNLESS OTHERWISE SPECIFIED
 FRAC: ± 1/16 0.XX: ± 0.01
 ANGLES: ± 1° 0.XXX: ± 0.005

TITLE: DEVICE TAG LEGEND	
CLIENT:	PROJECT:
DRAWN BY:	DRAWN DATE:
DRAWING NAME: 0000-XXRL-02.VSD	P.O.:
SCALE: NONE	REVISION: 0

ELECTRICAL

	WIRING PROVIDED BY OTHERS		RESISTOR
	INTERNAL WIRING OR COMPONENTS		VARISTOR
	NON-WIRE JUMPERS		CAPACITOR
	STRANDED COPPER WIRE		HAND-OFF-AUTO SWITCH
	TWISTED PAIR CABLE WITH SHIELD & DRAIN		TWO POSITION SWITCH
	MOLDED CABLE		FLOW SWITCH
	SPECIAL CABLE		LIQUID LEVEL SWITCH
	INTEGRAL CABLE		TEMPERATURE SWITCH
	CAT5E CABLE		NORMALLY OPEN PUSH-BUTTON
	PANEL PANEL BOUNDARY		NORMALLY CLOSED PUSH-BUTTON
	DEVICE AND COMPONENT BOUNDARIES		LINE REACTOR
	VARIABLE FREQUENCY DRIVE		SIGNAL POLE SWITCH
	SEAL-OFF CONNECTOR		PRESSURE SWITCH
	SURGE PROTECTION DEVICE		WIRELESS LINK
	LOAD		
	MOTOR		
	TRANSFORMER		
	SHIELD		
	PLUG CONNECTOR		
	INLINE CONNECTOR (SPLICE, WIRE NUT, ETC)		
	GROUND		
	TERMINAL		
	COIL		
	LIGHT WITH COLOR		
	CIRCUIT BREAKER		
	FUSE		
	NORMALLY OPEN CONTACT		
	NORMALLY CLOSED CONTACT		
	OVERLOAD RELAY		

REV	DATE	BY	DESCRIPTION
1			
2			
3			
4			



www.intuitech.com

THIS DRAWING IS THE INTELLECTUAL PROPERTY OF INTUITECH AND MAY NOT BE REPRODUCED IN FULL OR IN PART FOR ANY PURPOSE ASIDE FROM THE PROJECT AS SPECIFIED ON THIS DOCUMENT

DIMENSIONAL TOLERANCES ARE AS FOLLOWS, UNLESS OTHERWISE SPECIFIED

FRAC: ± 1/16	0.XX: ± 0.01
ANGLES: ± 1°	0.XXX: ± 0.005

TITLE: ELECTRICAL SYMBOL LEGEND	
CLIENT:	PROJECT:
DRAWN BY:	DRAWN DATE:
DRAWING NAME: 0000-XXRL-03.VSD	P.O.:
SCALE: NONE	REVISION: 0

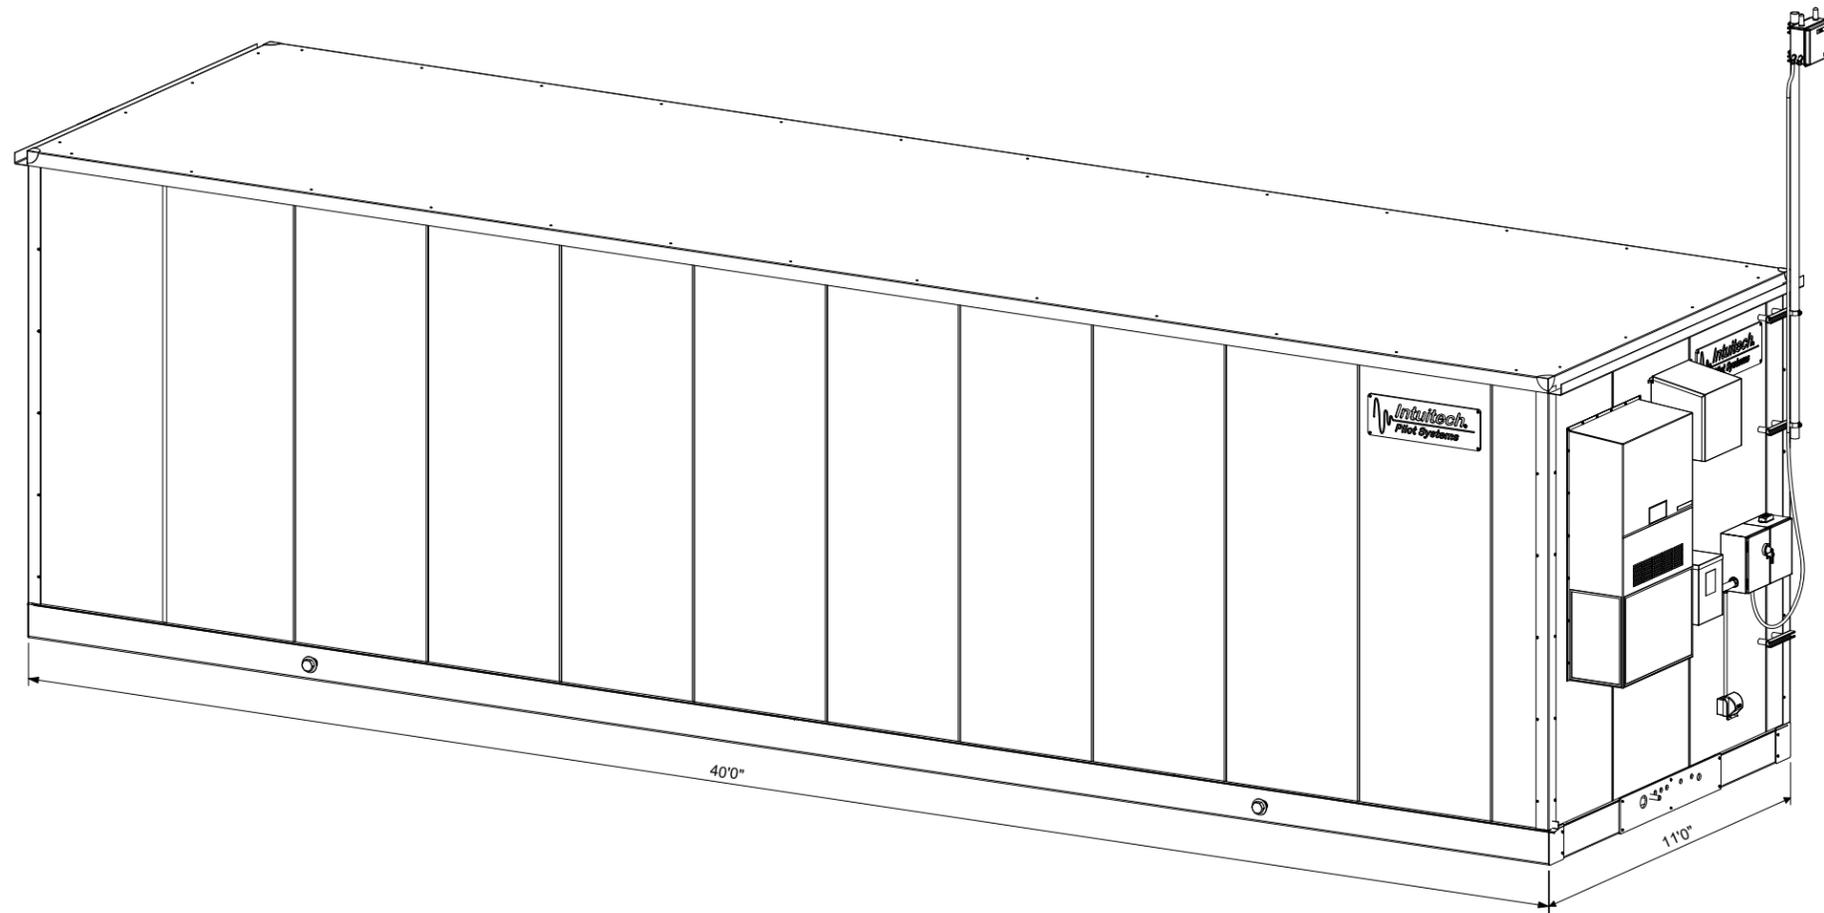

NOTES:

- ESTIMATED DRY WEIGHT: 24,500 LBS


REV	DATE	BY	CHECKED	DESCRIPTION
1	03/09/21	DGW		UPDATED AS PER AS BUILTS
2				
3				
4				


www.intuitech.com

THIS DRAWING IS THE INTELLECTUAL PROPERTY OF INTUITECH
 AND MAY NOT BE REPRODUCED IN FULL OR IN PART FOR ANY
 PURPOSE ASIDE FROM THE PROJECT SPECIFIED ON THIS DOCUMENT

DIMENSIONAL TOLERANCES ARE AS FOLLOWS UNLESS OTHERWISE SPECIFIED	
FRAC: ±1/16	0.XX: ±0.01
ANGLES: ±1°	0.XXX: ±0.005

TITLE: PILOT MODULE ENCLOSURE B500 PILOT ENCLOSURE MODULE - GENERAL ARRANGEMENT FRONT DIMETRIC VIEW	
CLIENT: INTUITECH	PROJECT: 1675
DRAWN BY: DGW	DRAWN DATE: 11/18/2020
DRAWING NAME: 1675-X0GA-01	P.O.:
SCALE: NONE	REVISION: 1

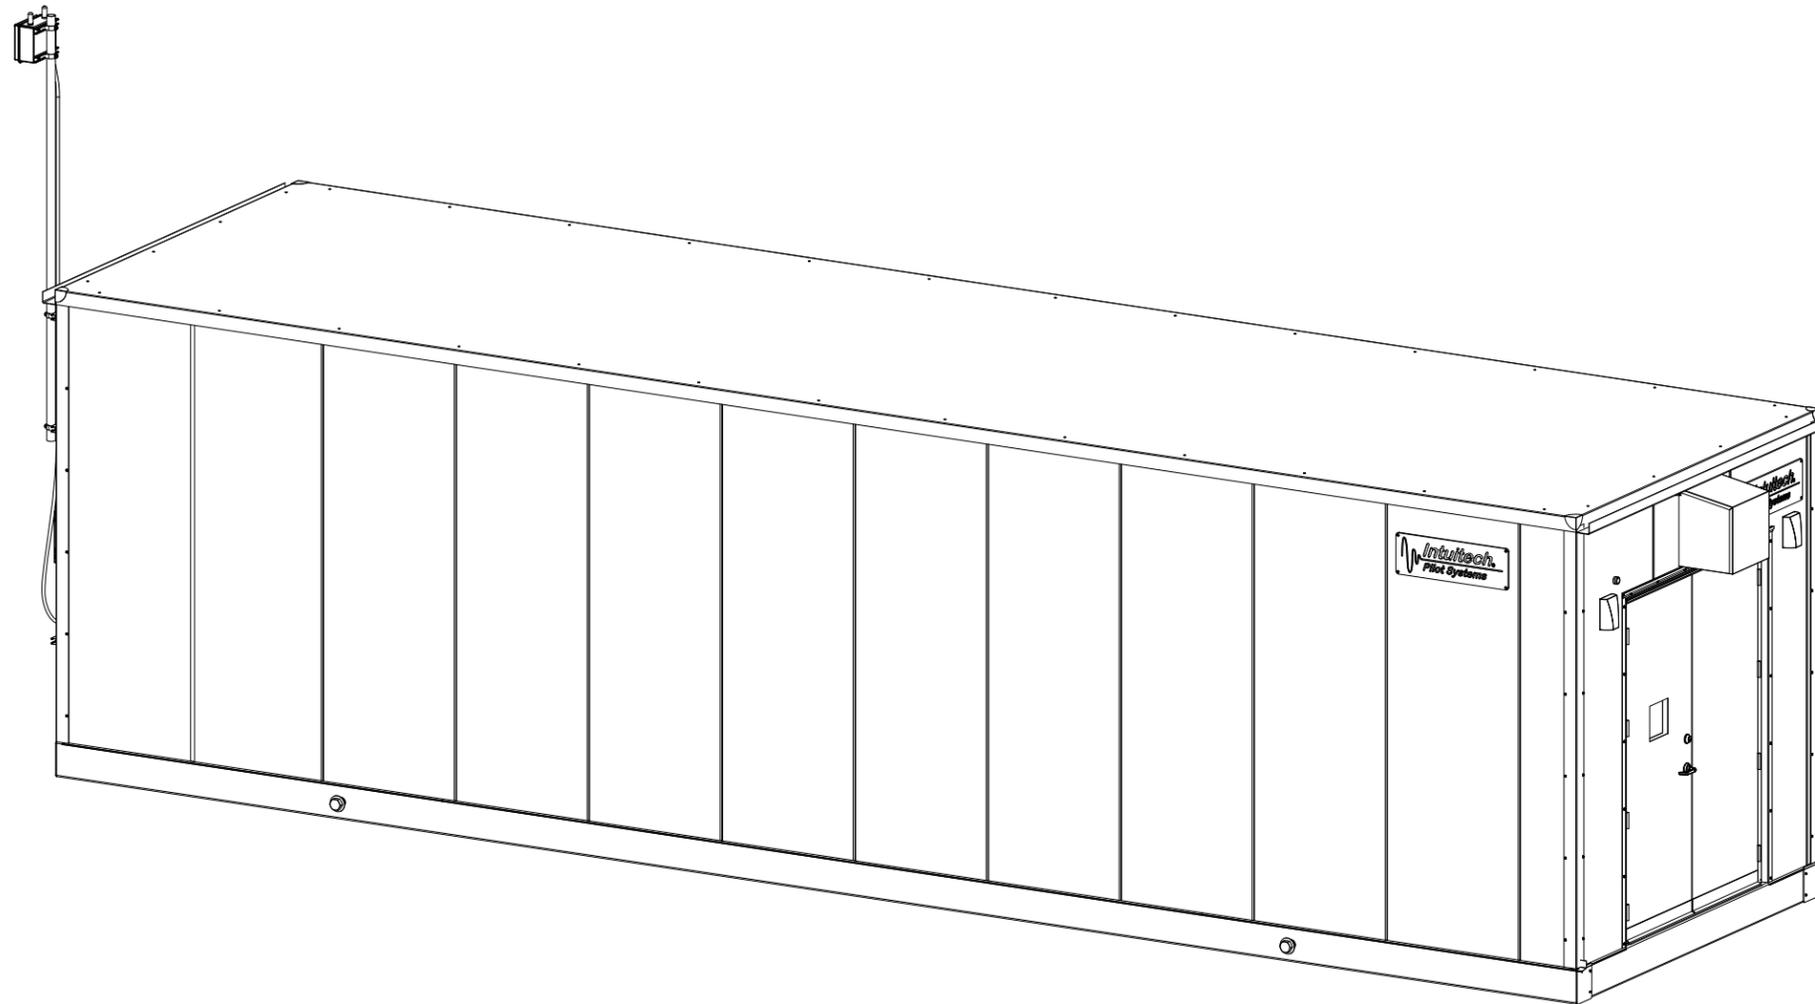

REV	DATE	BY	CHECKED	DESCRIPTION
1	03/09/21	DGW		UPDATED AS PER AS BUILTS
2				
3				
4				




THIS DRAWING IS THE INTELLECTUAL PROPERTY OF INTUITECH AND MAY NOT BE REPRODUCED IN FULL OR IN PART FOR ANY PURPOSE ASIDE FROM THE PROJECT SPECIFIED ON THIS DOCUMENT


DIMENSIONAL TOLERANCES ARE AS FOLLOWS UNLESS OTHERWISE SPECIFIED

FRAC: ±1/16 0.XX: ±0.01
 ANGLES: ±1° 0.XXX: ±0.005

TITLE: PILOT MODULE ENCLOSURE B500 PILOT ENCLOSURE MODULE - GENERAL ARRANGEMENT BACK DIMETRIC VIEW	
CLIENT: INTUITECH	PROJECT: 1675
DRAWN BY: DGW	DRAWN DATE: 11/18/2020
DRAWING NAME: 1675-X0GA-02	P.O.:
SCALE: NONE	REVISION: 1

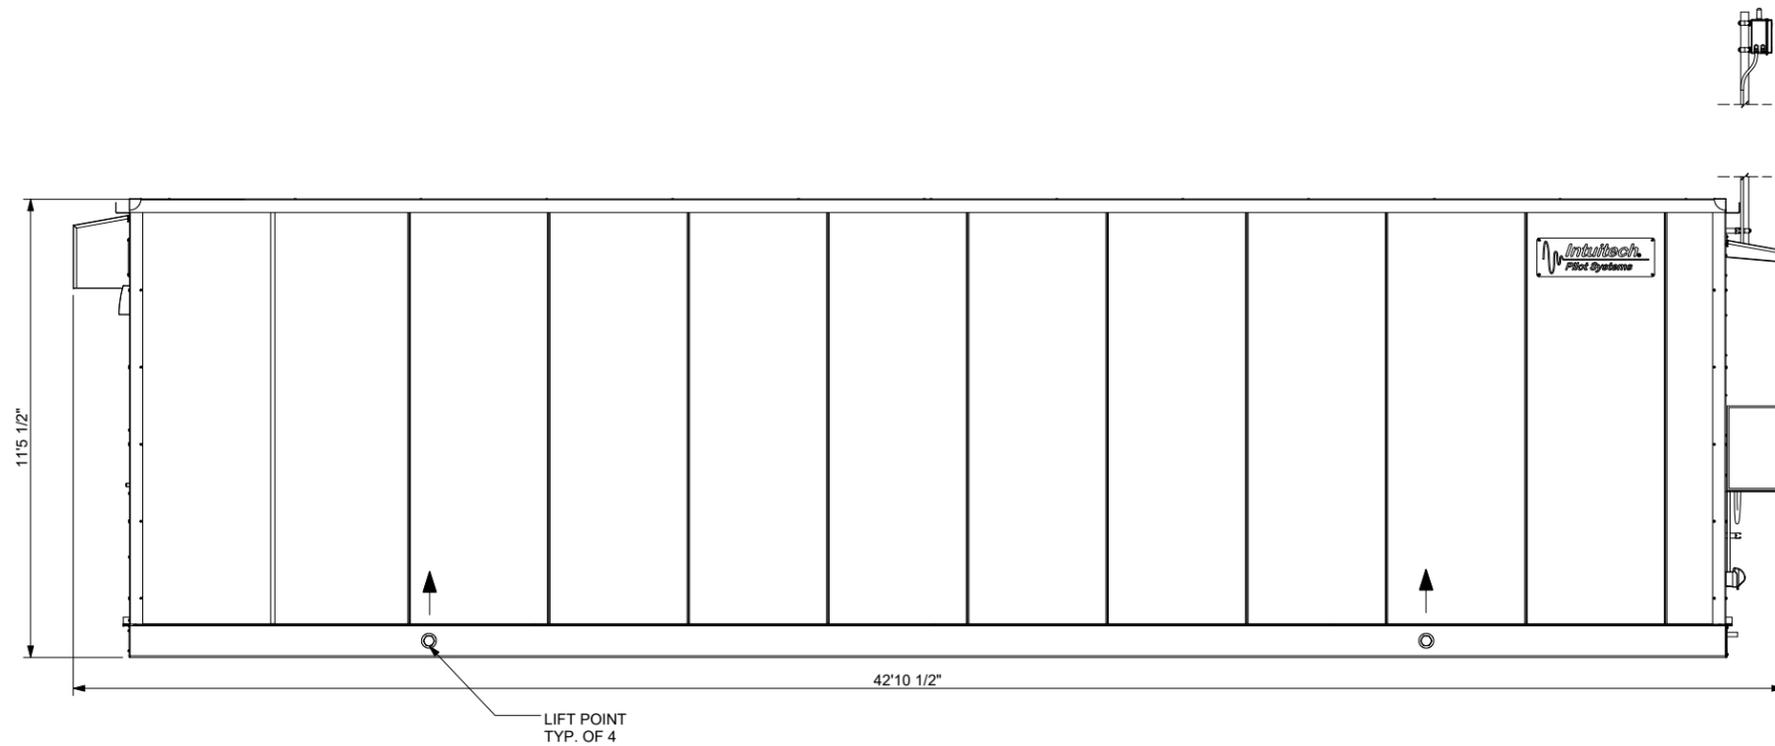

FRONT VIEW

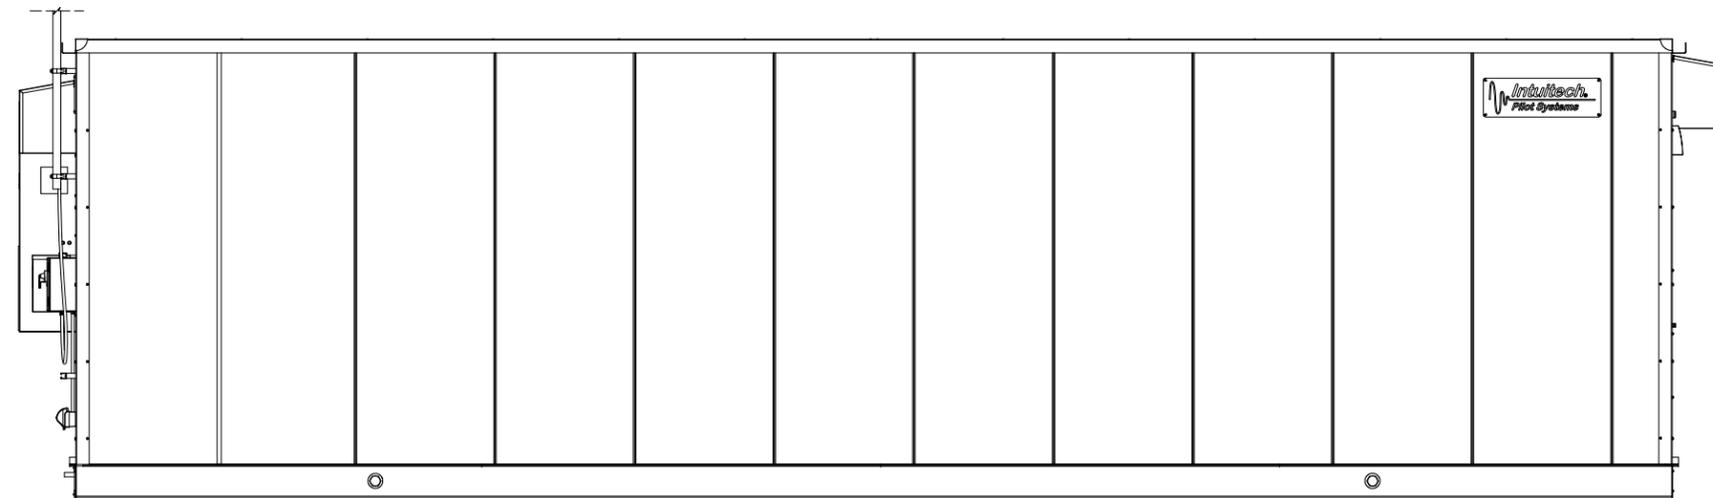

BACK VIEW

REV	DATE	BY	CHECKED	DESCRIPTION
1	03/09/21	DGW		UPDATED AS PER AS BUILTS
2				
3				
4				




THIS DRAWING IS THE INTELLECTUAL PROPERTY OF INTUITECH AND MAY NOT BE REPRODUCED IN FULL OR IN PART FOR ANY PURPOSE ASIDE FROM THE PROJECT SPECIFIED ON THIS DOCUMENT


DIMENSIONAL TOLERANCES ARE AS FOLLOWS UNLESS OTHERWISE SPECIFIED

FRAC: ±1/16 0.XX: ±0.01
 ANGLES: ±1° 0.XXX: ±0.005

TITLE: PILOT MODULE ENCLOSURE B500 PILOT ENCLOSURE MODULE - GENERAL ARRANGEMENT FRONT & BACK VIEWS	
CLIENT: INTUITECH	PROJECT: 1675
DRAWN BY: DGW	DRAWN DATE: 11/18/2020
DRAWING NAME: 1675-X0GA-03	P.O.:
SCALE: NONE	REVISION: 1

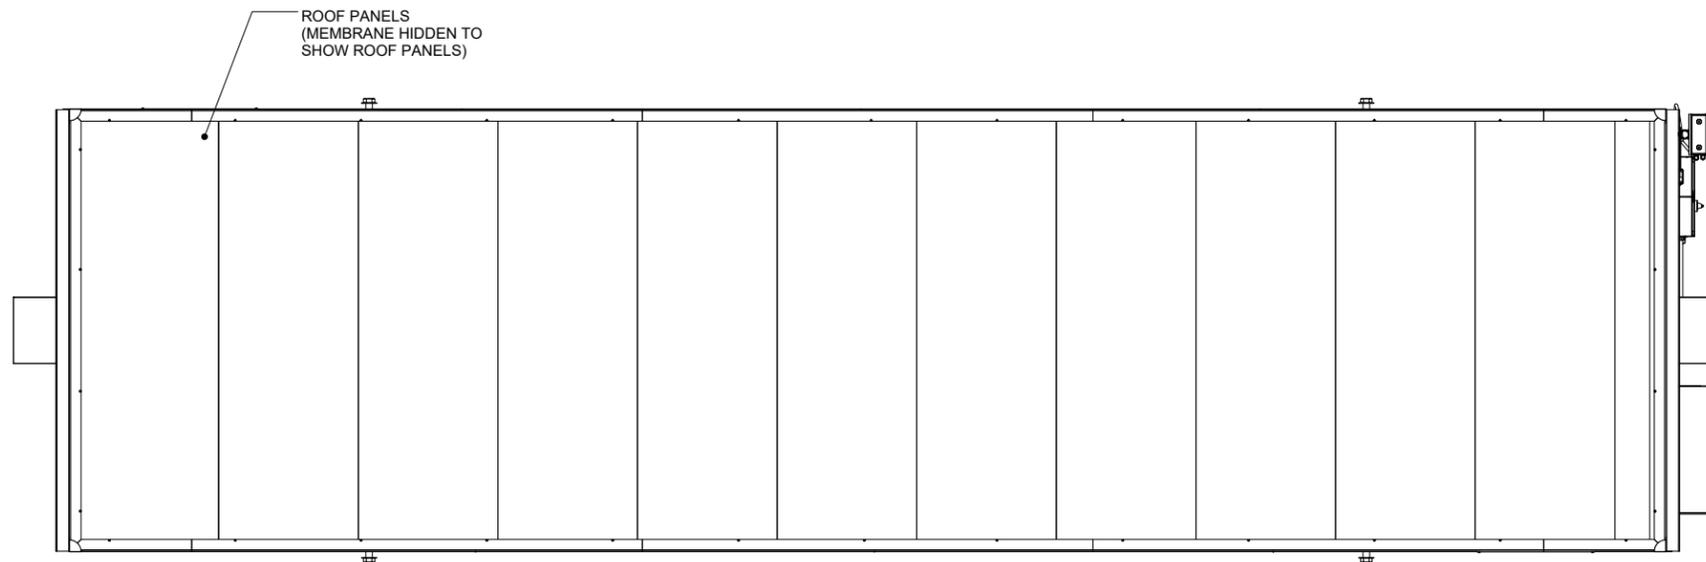

TOP VIEW

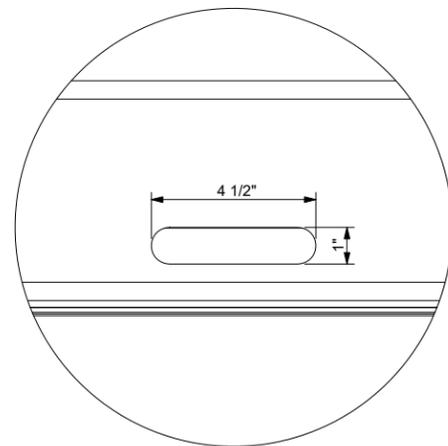

DETAIL A
SHIPPING ANCHOR SLOT
TYP OF 8



BOTTOM VIEW


REV	DATE	BY	CHECKED	DESCRIPTION
1	03/09/21	DGW		UPDATED AS PER AS BUILTS
2				
3				
4				


Intuitech
 www.intuitech.com


THIS DRAWING IS THE INTELLECTUAL PROPERTY OF INTUITECH AND MAY NOT BE REPRODUCED IN FULL OR IN PART FOR ANY PURPOSE ASIDE FROM THE PROJECT SPECIFIED ON THIS DOCUMENT

DIMENSIONAL TOLERANCES ARE AS FOLLOWS UNLESS OTHERWISE SPECIFIED
 FRAC: ±1/16 0.XX: ±0.01
 ANGLES: ±1° 0.XXX: ±0.005


TITLE: PILOT MODULE ENCLOSURE B500 PILOT ENCLOSURE MODULE - GENERAL ARRANGEMENT TOP & BOTTOM VIEWS	
CLIENT: INTUITECH	PROJECT: 1675
DRAWN BY: DGW	DRAWN DATE: 11/18/2020
DRAWING NAME: 1675-X0GA-04	P.O.:
SCALE: NONE	REVISION: 1

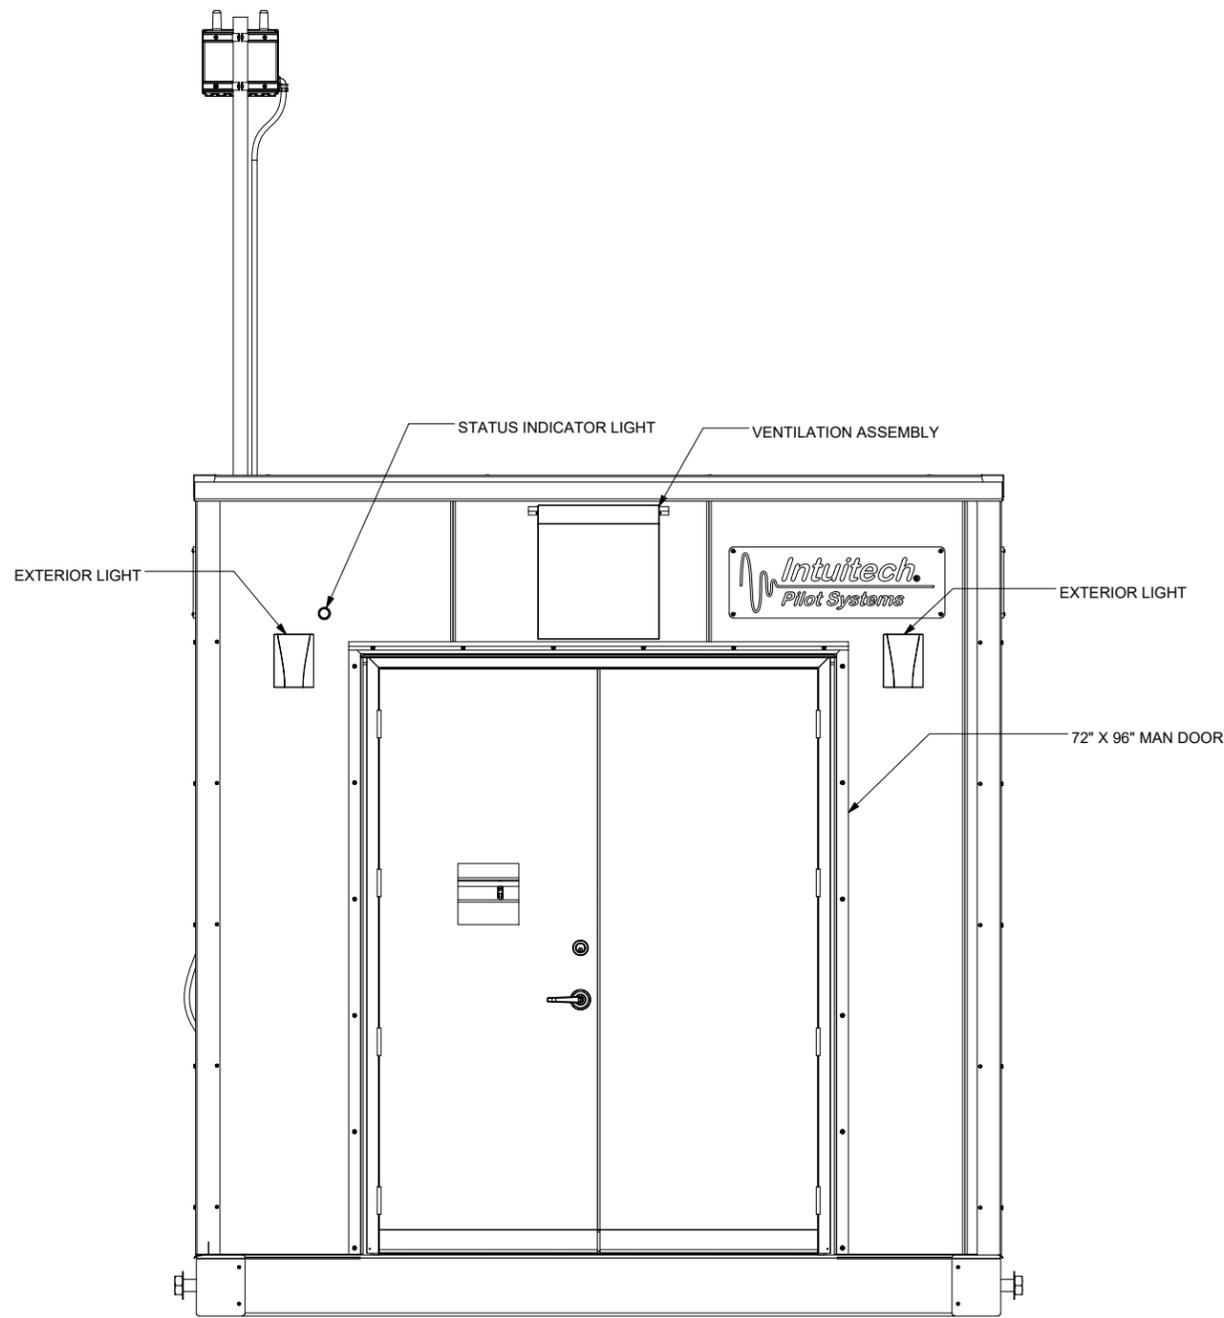

LEFT VIEW

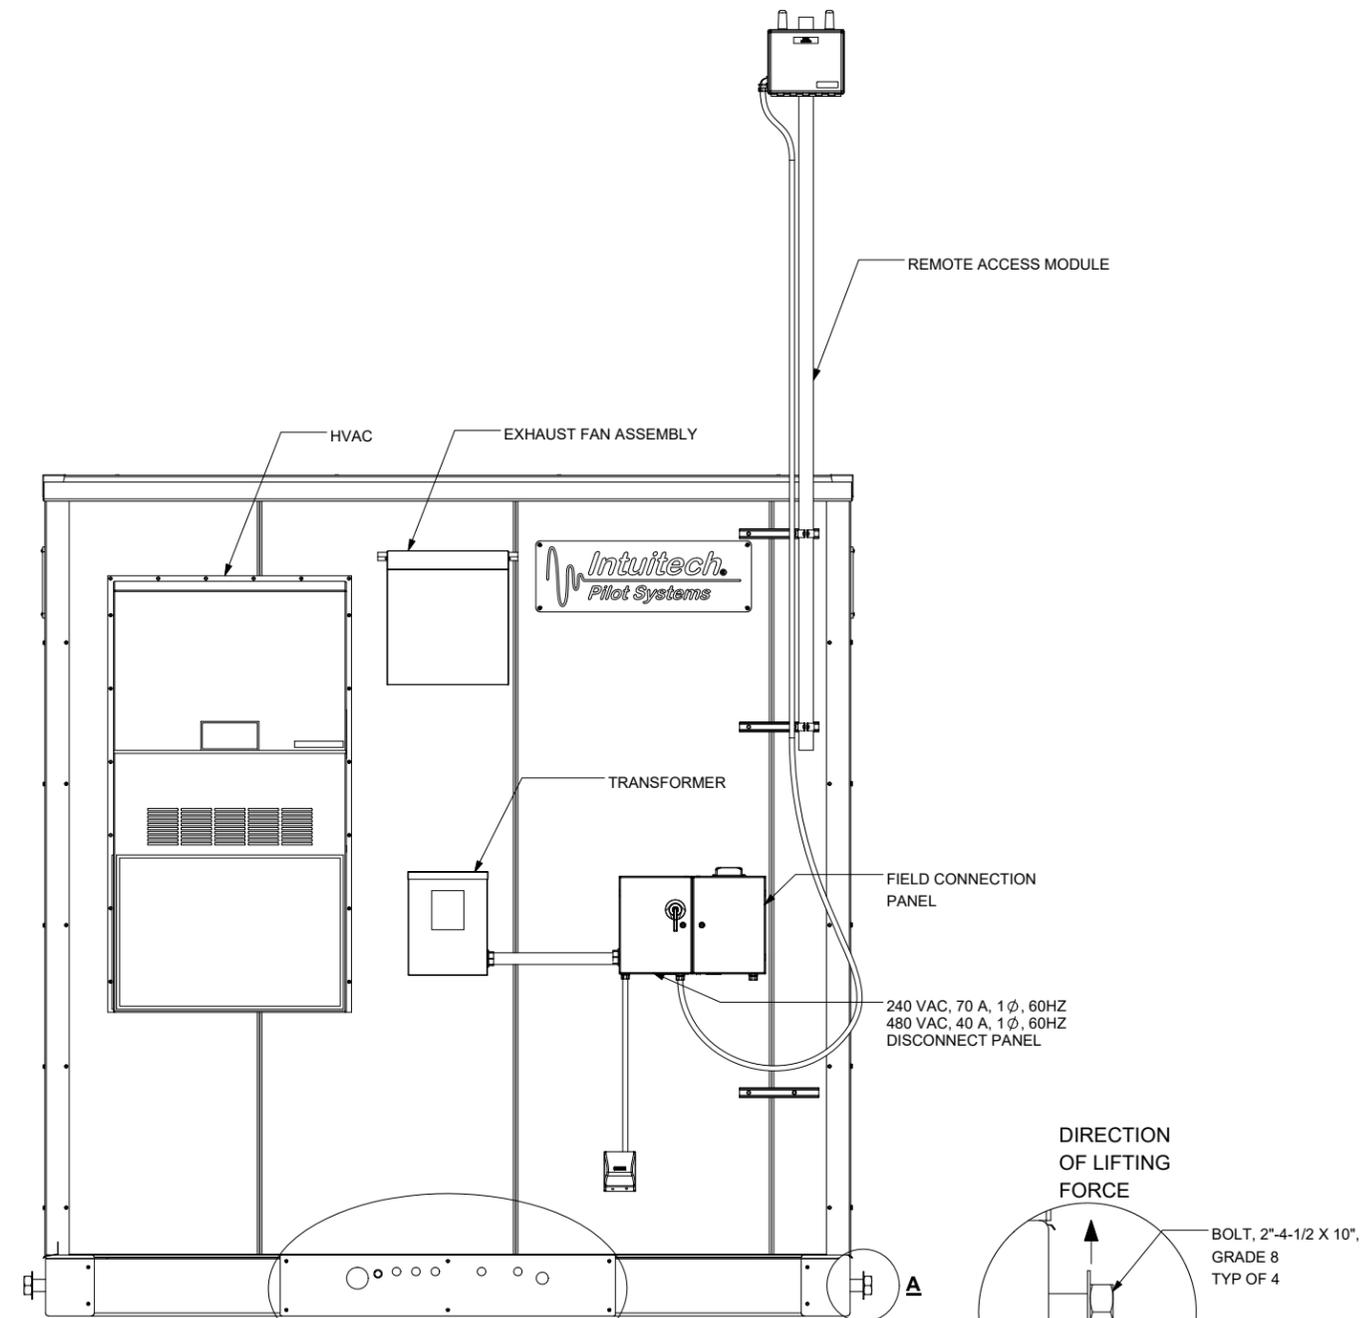

RIGHT VIEW

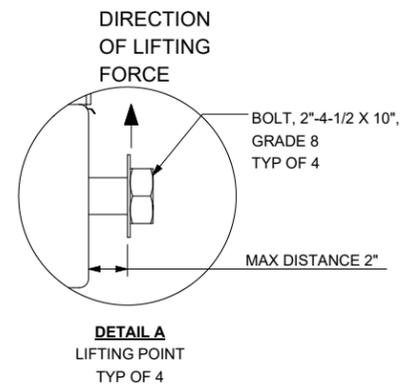

REV	DATE	BY	CHECKED	DESCRIPTION
1	03/09/21	DGW		UPDATED AS PER AS BUILTS
2				
3				
4				



THIS DRAWING IS THE INTELLECTUAL PROPERTY OF INTUITECH AND MAY NOT BE REPRODUCED IN FULL OR IN PART FOR ANY PURPOSE ASIDE FROM THE PROJECT SPECIFIED ON THIS DOCUMENT

DIMENSIONAL TOLERANCES ARE AS FOLLOWS UNLESS OTHERWISE SPECIFIED

FRAC: ±1/16 0.XX: ±0.01
 ANGLES: ±1° 0.XXX: ±0.005


**TITLE: PILOT MODULE ENCLOSURE B500
 PILOT ENCLOSURE MODULE - GENERAL ARRANGEMENT LEFT & RIGHT VIEWS**

CLIENT: INTUITECH PROJECT: 1675


DRAWN BY: DGW DRAWN DATE: 11/18/2020

DRAWING NAME: 1675-X0GA-05 P.O.:


SCALE: NONE REVISION: 1

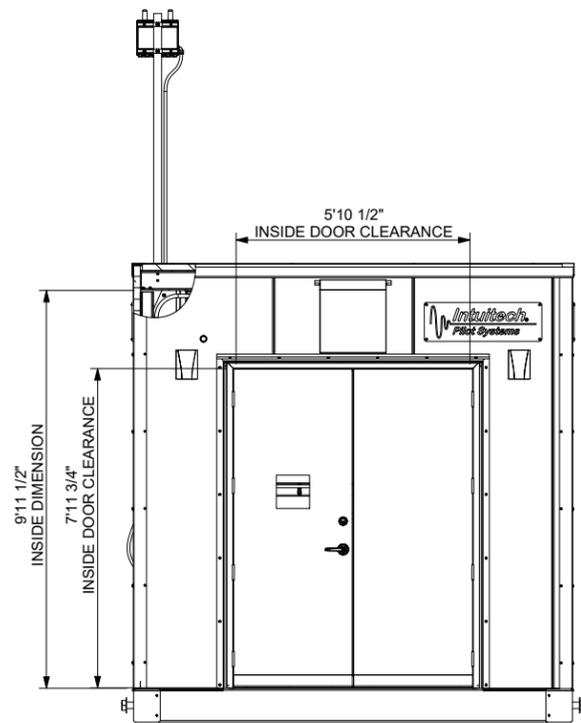

LEFT VIEW

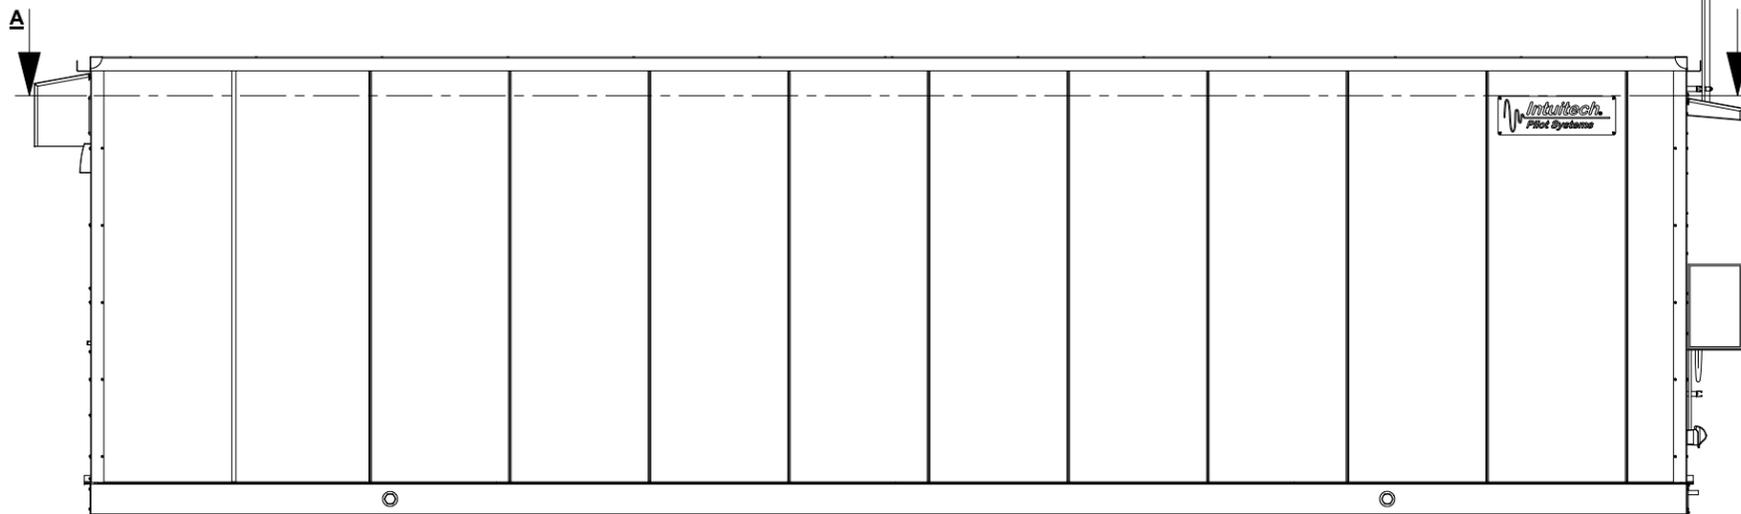

FRONT VIEW

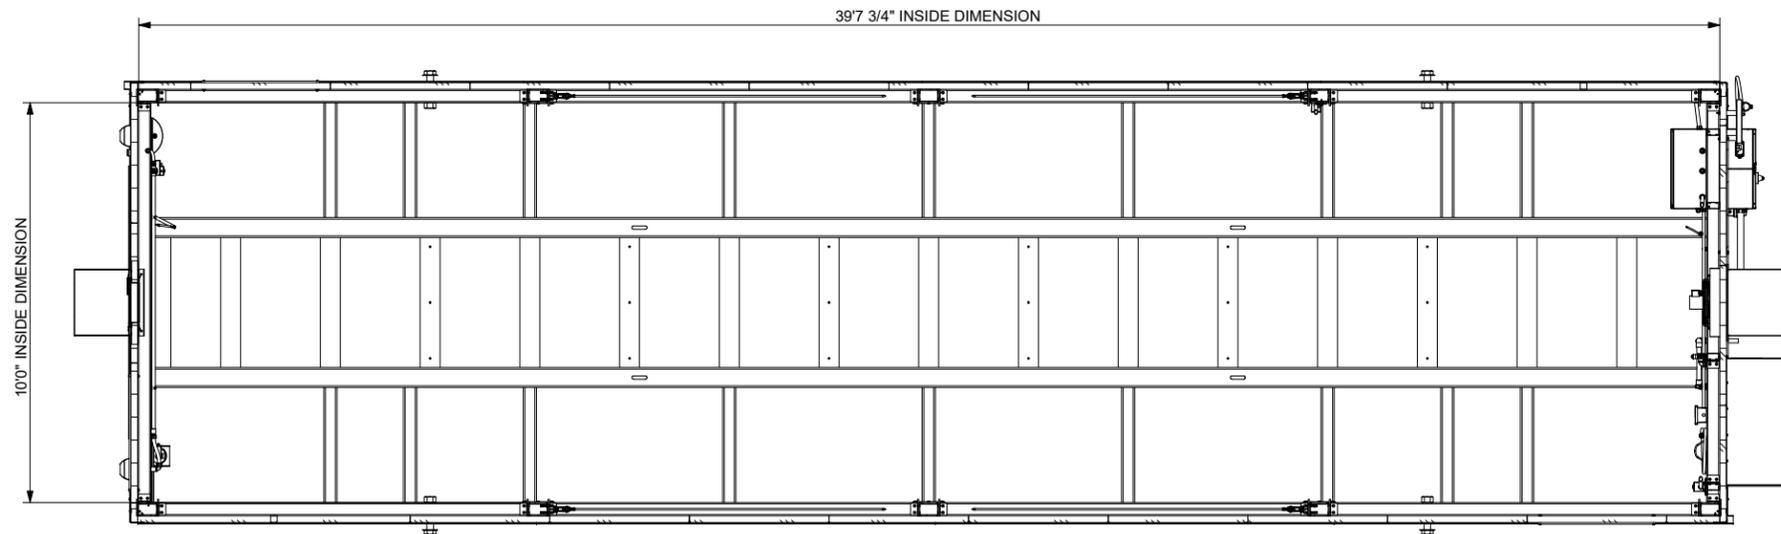

SECTION A-A

REV	DATE	BY	CHECKED	DESCRIPTION
1	03/09/21	DGW		UPDATED AS PER AS BUILTS
2				
3				
4				



THIS DRAWING IS THE INTELLECTUAL PROPERTY OF INTUITECH AND MAY NOT BE REPRODUCED IN FULL OR IN PART FOR ANY PURPOSE ASIDE FROM THE PROJECT SPECIFIED ON THIS DOCUMENT


DIMENSIONAL TOLERANCES ARE AS FOLLOWS UNLESS OTHERWISE SPECIFIED

FRAC: ±1/16 0.XX: ±0.01
ANGLES: ±1° 0.XXX: ±0.005

**TITLE: PILOT MODULE ENCLOSURE B500
PILOT ENCLOSURE MODULE - GENERAL ARRANGEMENT**

CLIENT: INTUITECH	PROJECT: 1675
DRAWN BY: DGW	DRAWN DATE: 11/18/2020
DRAWING NAME: 1675-X0GA-06	P.O.:
SCALE: NONE	REVISION: 1

SUPPLY VOLTAGE:
240VAC, 70A, 1PHASE, 60HZ OR
480VAC, 40A, 1PHASE, 60HZ
SCCR 10KA

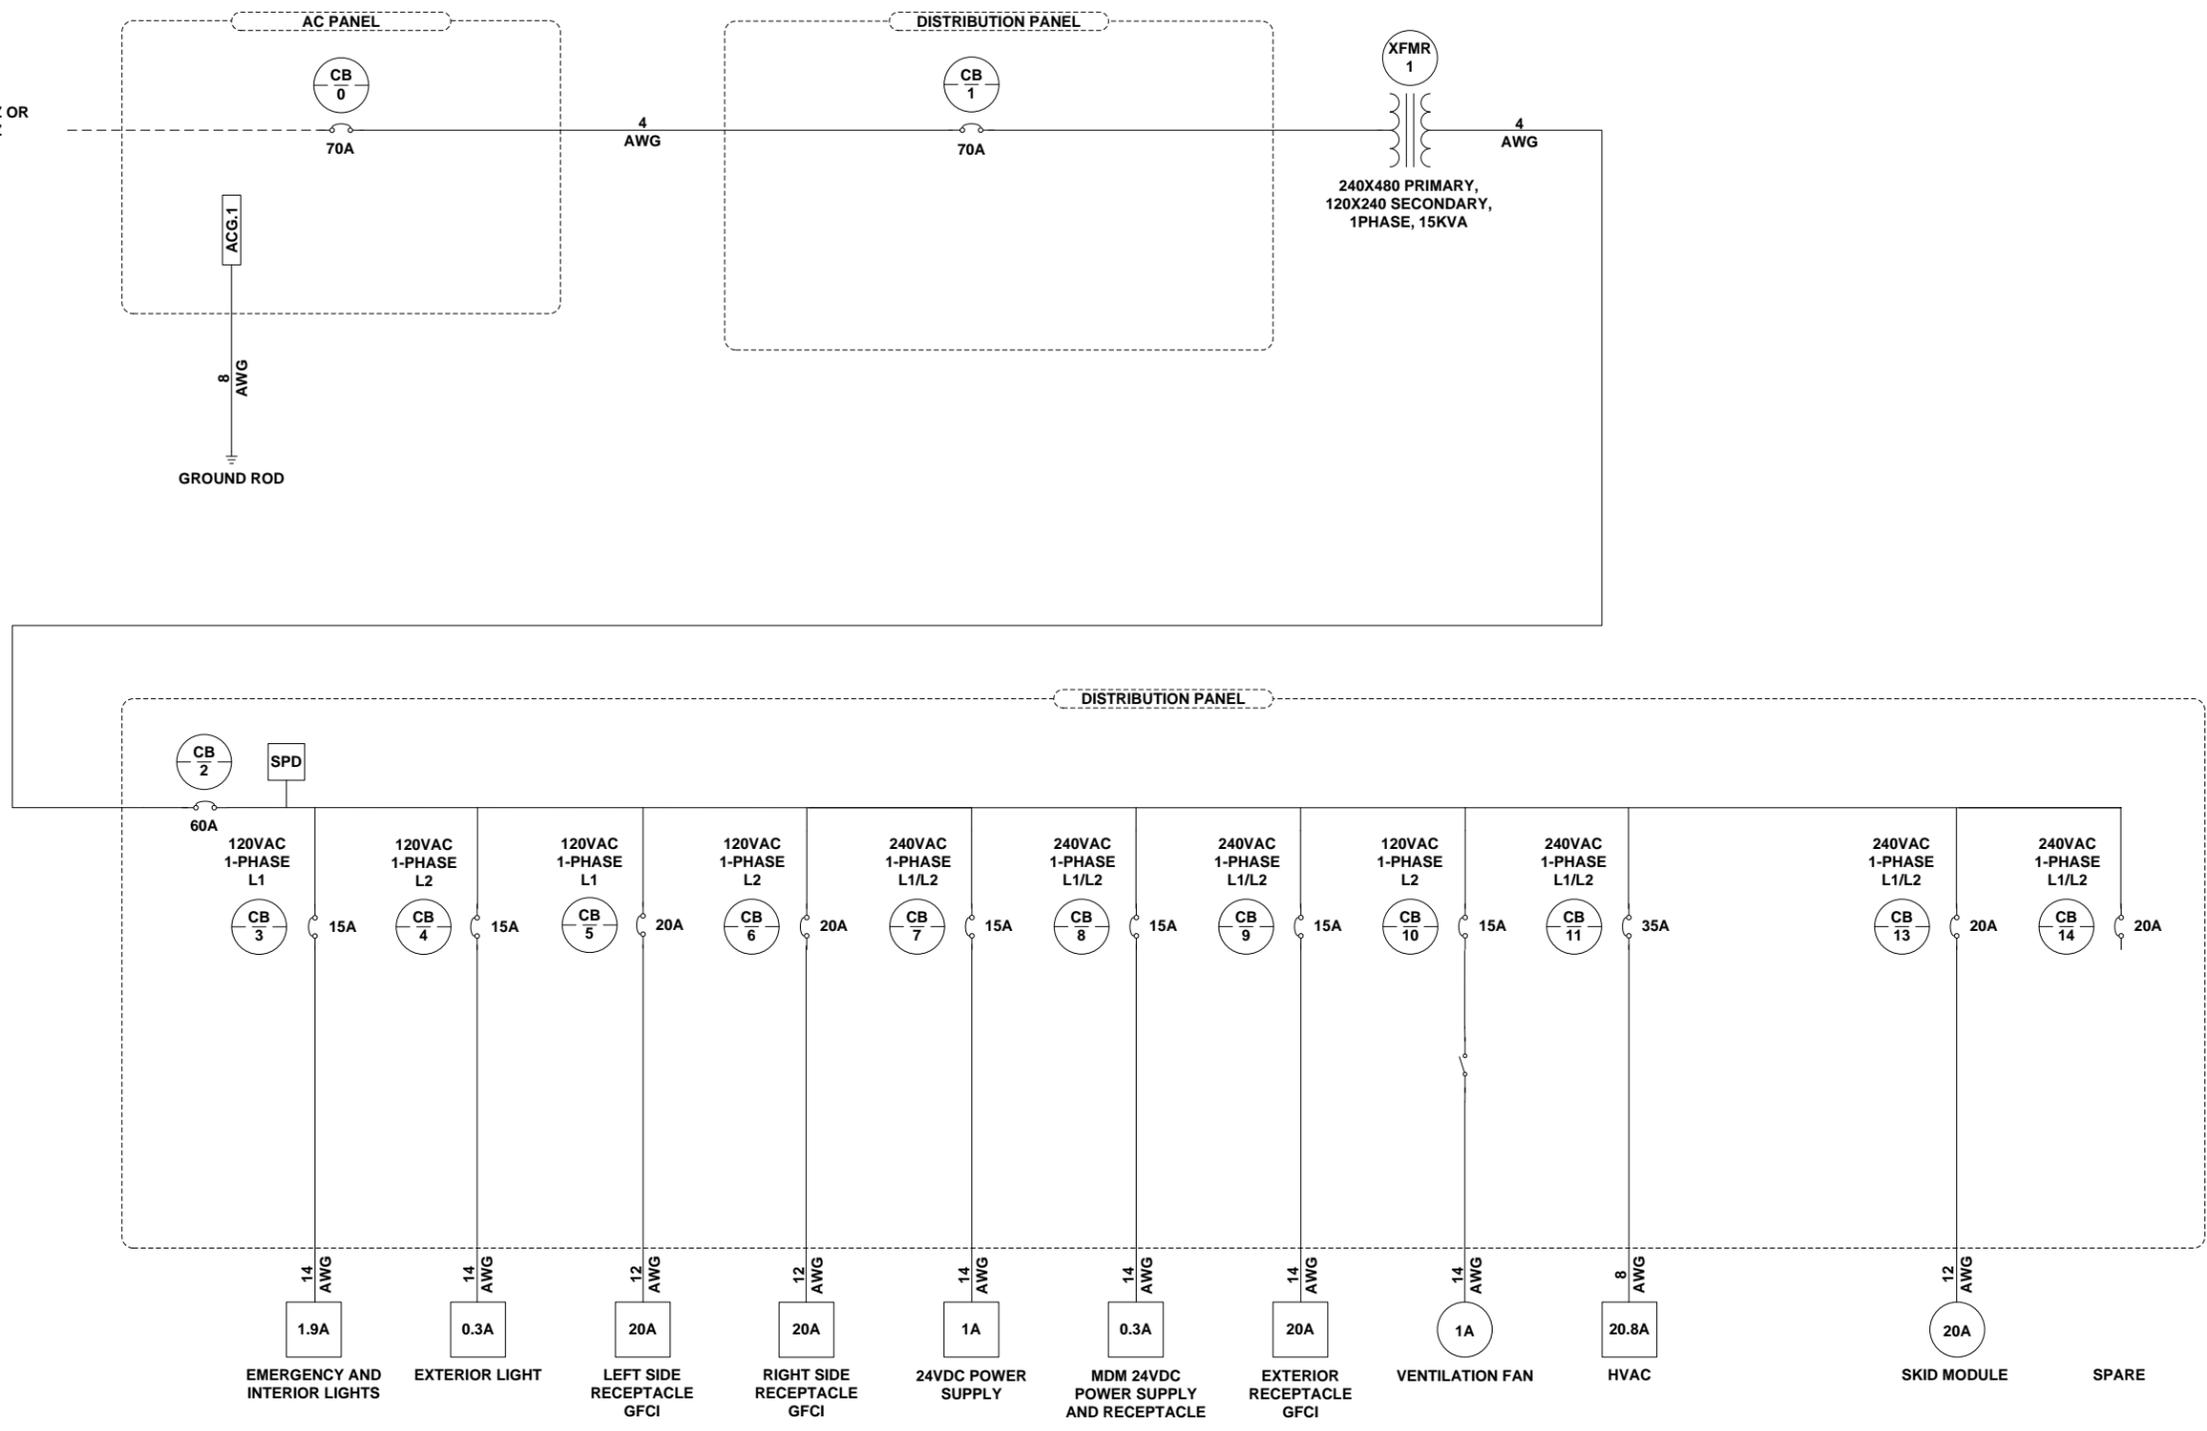

REV	DATE	BY	DESCRIPTION
1	02/05/21	DGW	ADDED EXTERIOR RECEPTACLE
2			
3			
4			



THIS DRAWING IS THE INTELLECTUAL PROPERTY OF INTUITECH AND MAY NOT BE REPRODUCED IN FULL OR IN PART FOR ANY PURPOSE ASIDE FROM THE PROJECT AS SPECIFIED ON THIS DOCUMENT

DIMENSIONAL TOLERANCES ARE AS FOLLOWS, UNLESS OTHERWISE SPECIFIED
 FRAC: ± 1/16 0.XX: ± 0.01
 ANGLES: ± 1° 0.XXX: ± 0.005

TITLE: B500 ENCLOSURE ONE LINE DIAGRAM	
CLIENT: INTUITECH	PROJECT: 1675
DRAWN BY: BNL	DRAWN DATE: 11-02-20
DRAWING NAME: 1675-X0LD-01	P.O.:
SCALE: NONE	REVISION: 1